


PLAN CHECK APPROVAL

This plan has been reviewed for conformance with CA Building Code and City Ordinances. Although this plan appears to meet minimum requirements of said Code and City Ordinances, this approval does not certify plans and designs adequacy, nor is any representation made that structure failure, or other structural related damage will not occur. Any permit issued pursuant hereto shall not constitute a recommendation or endorsement, but is permissive only.

Date: 1/31/17 Doug Rider
Signature

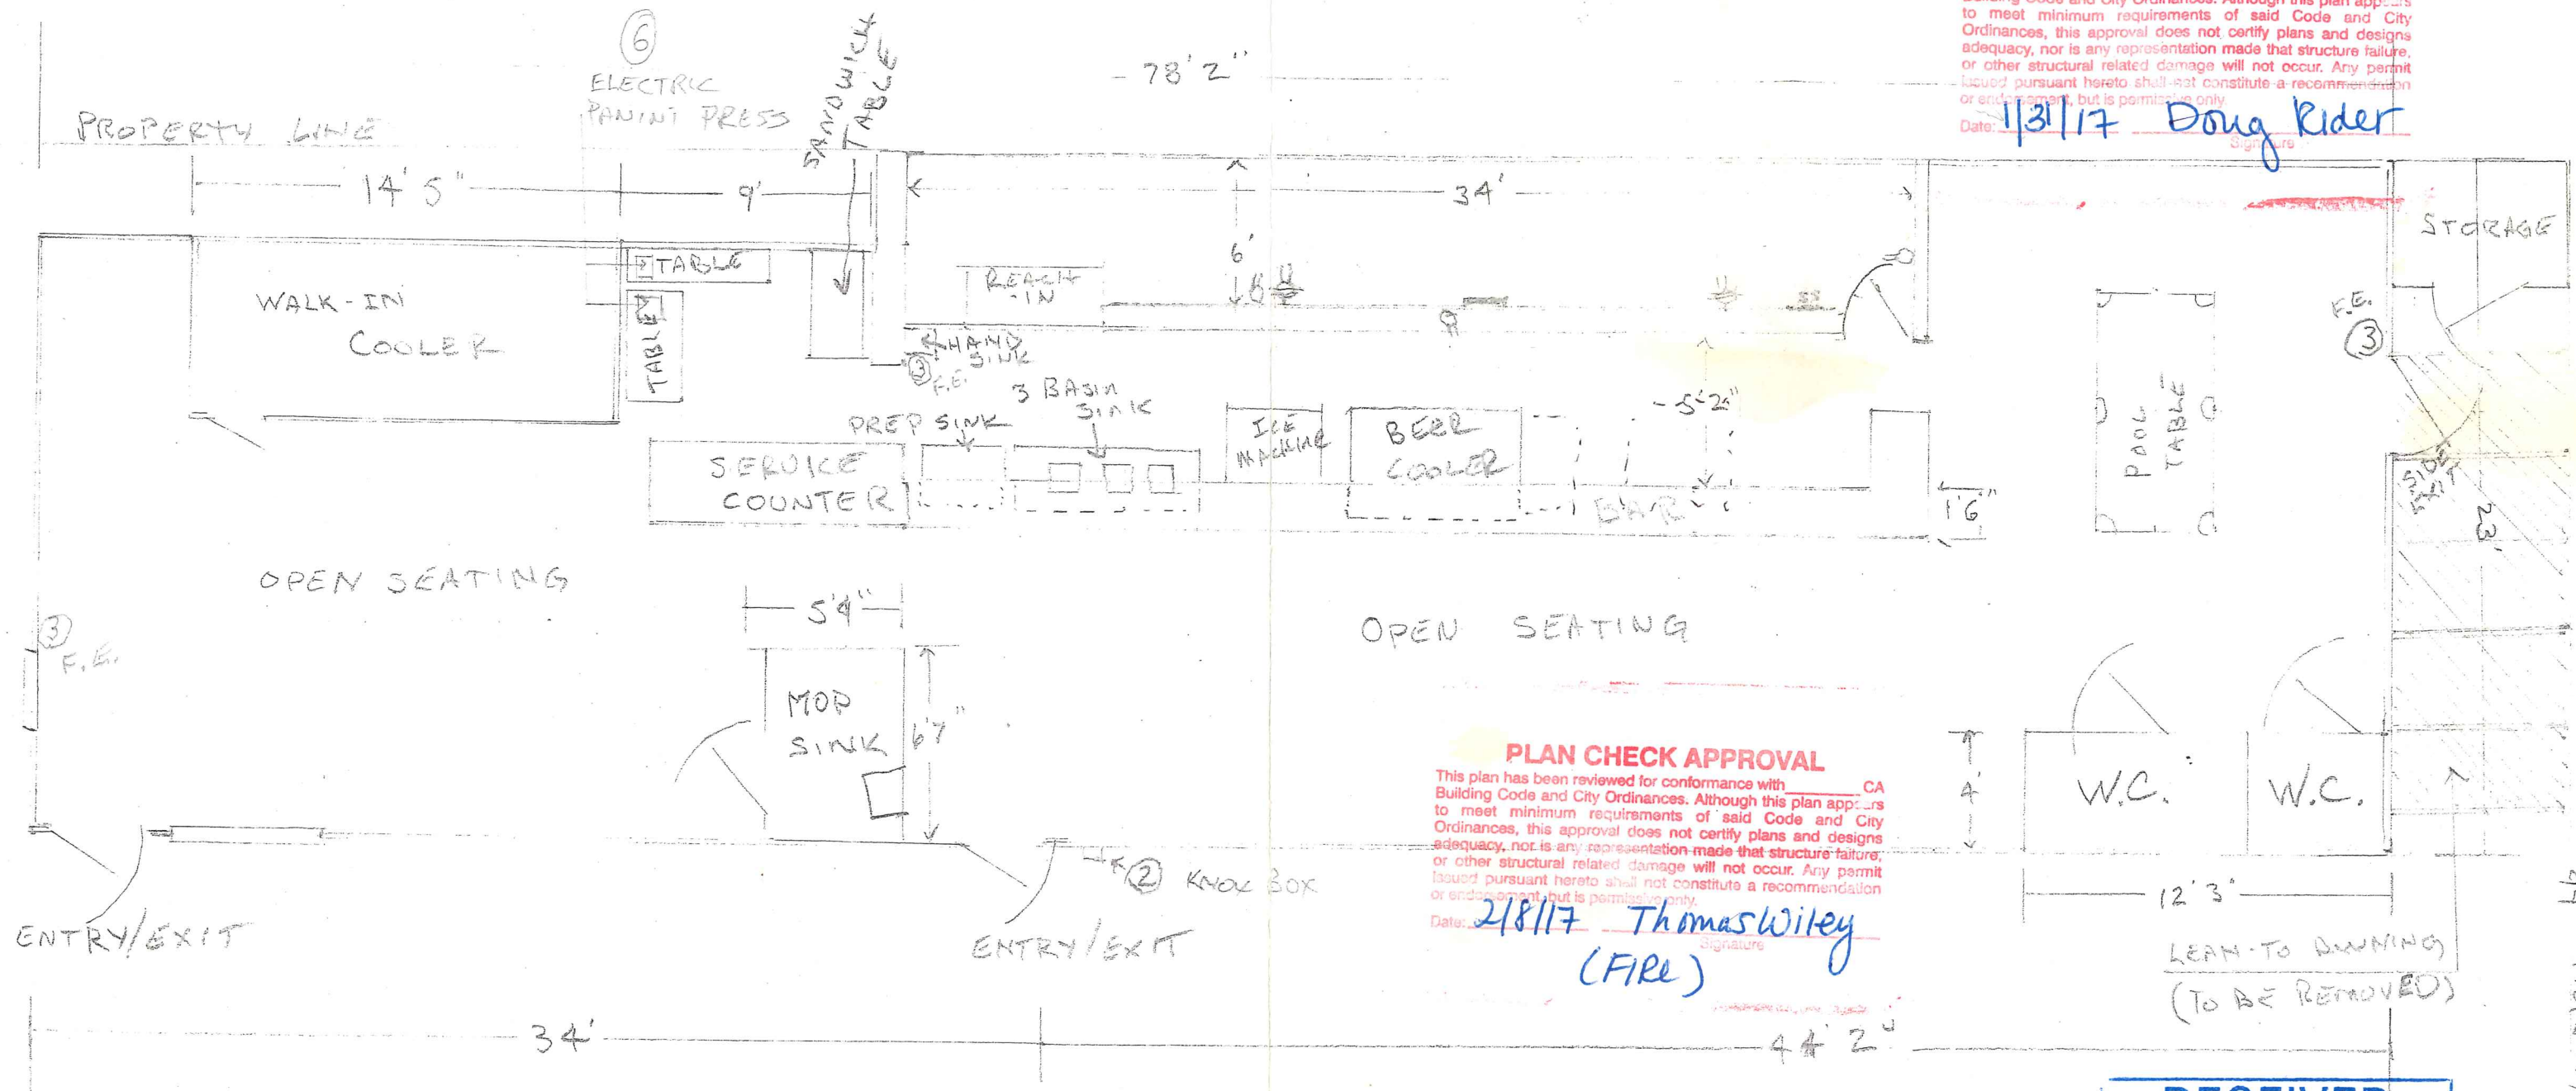

PLAN CHECK APPROVAL

This plan has been reviewed for conformance with CA Building Code and City Ordinances. Although this plan appears to meet minimum requirements of said Code and City Ordinances, this approval does not certify plans and designs adequacy, nor is any representation made that structure failure, or other structural related damage will not occur. Any permit issued pursuant hereto shall not constitute a recommendation or endorsement, but is permissive only.

Date: 2/8/17 Thomas Wiley
Signature (FIRE)

PARKING **JOB SITE COPY**

RECEIVED
FEB 02 2017
PERMIT CENTER
ALAMEDA, CA 94601

2030 CLEMENT AVE.
Drawn by KEITH RABICK
SCALE 3/16" = 1'
REV. 2

2030 CLEMENT AVE
CB17-0017

PROPERTY LINE 108'

CLEMENT AVE

